


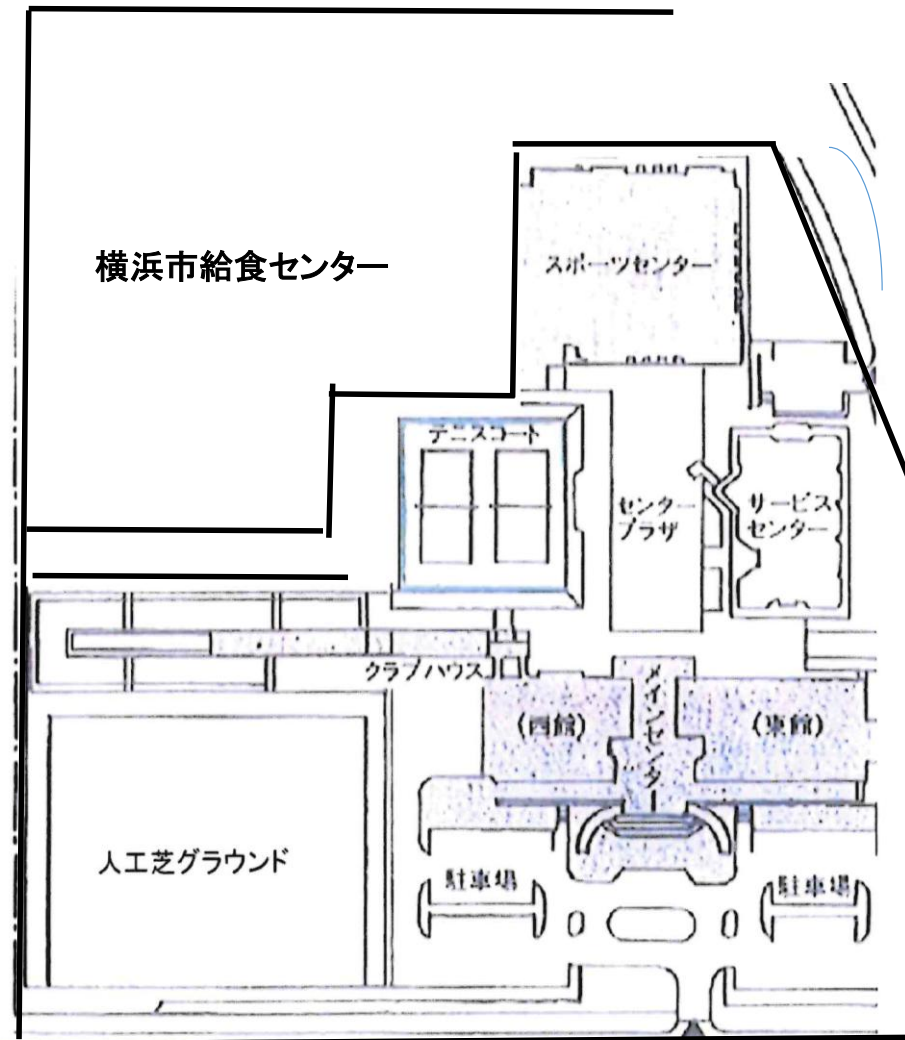


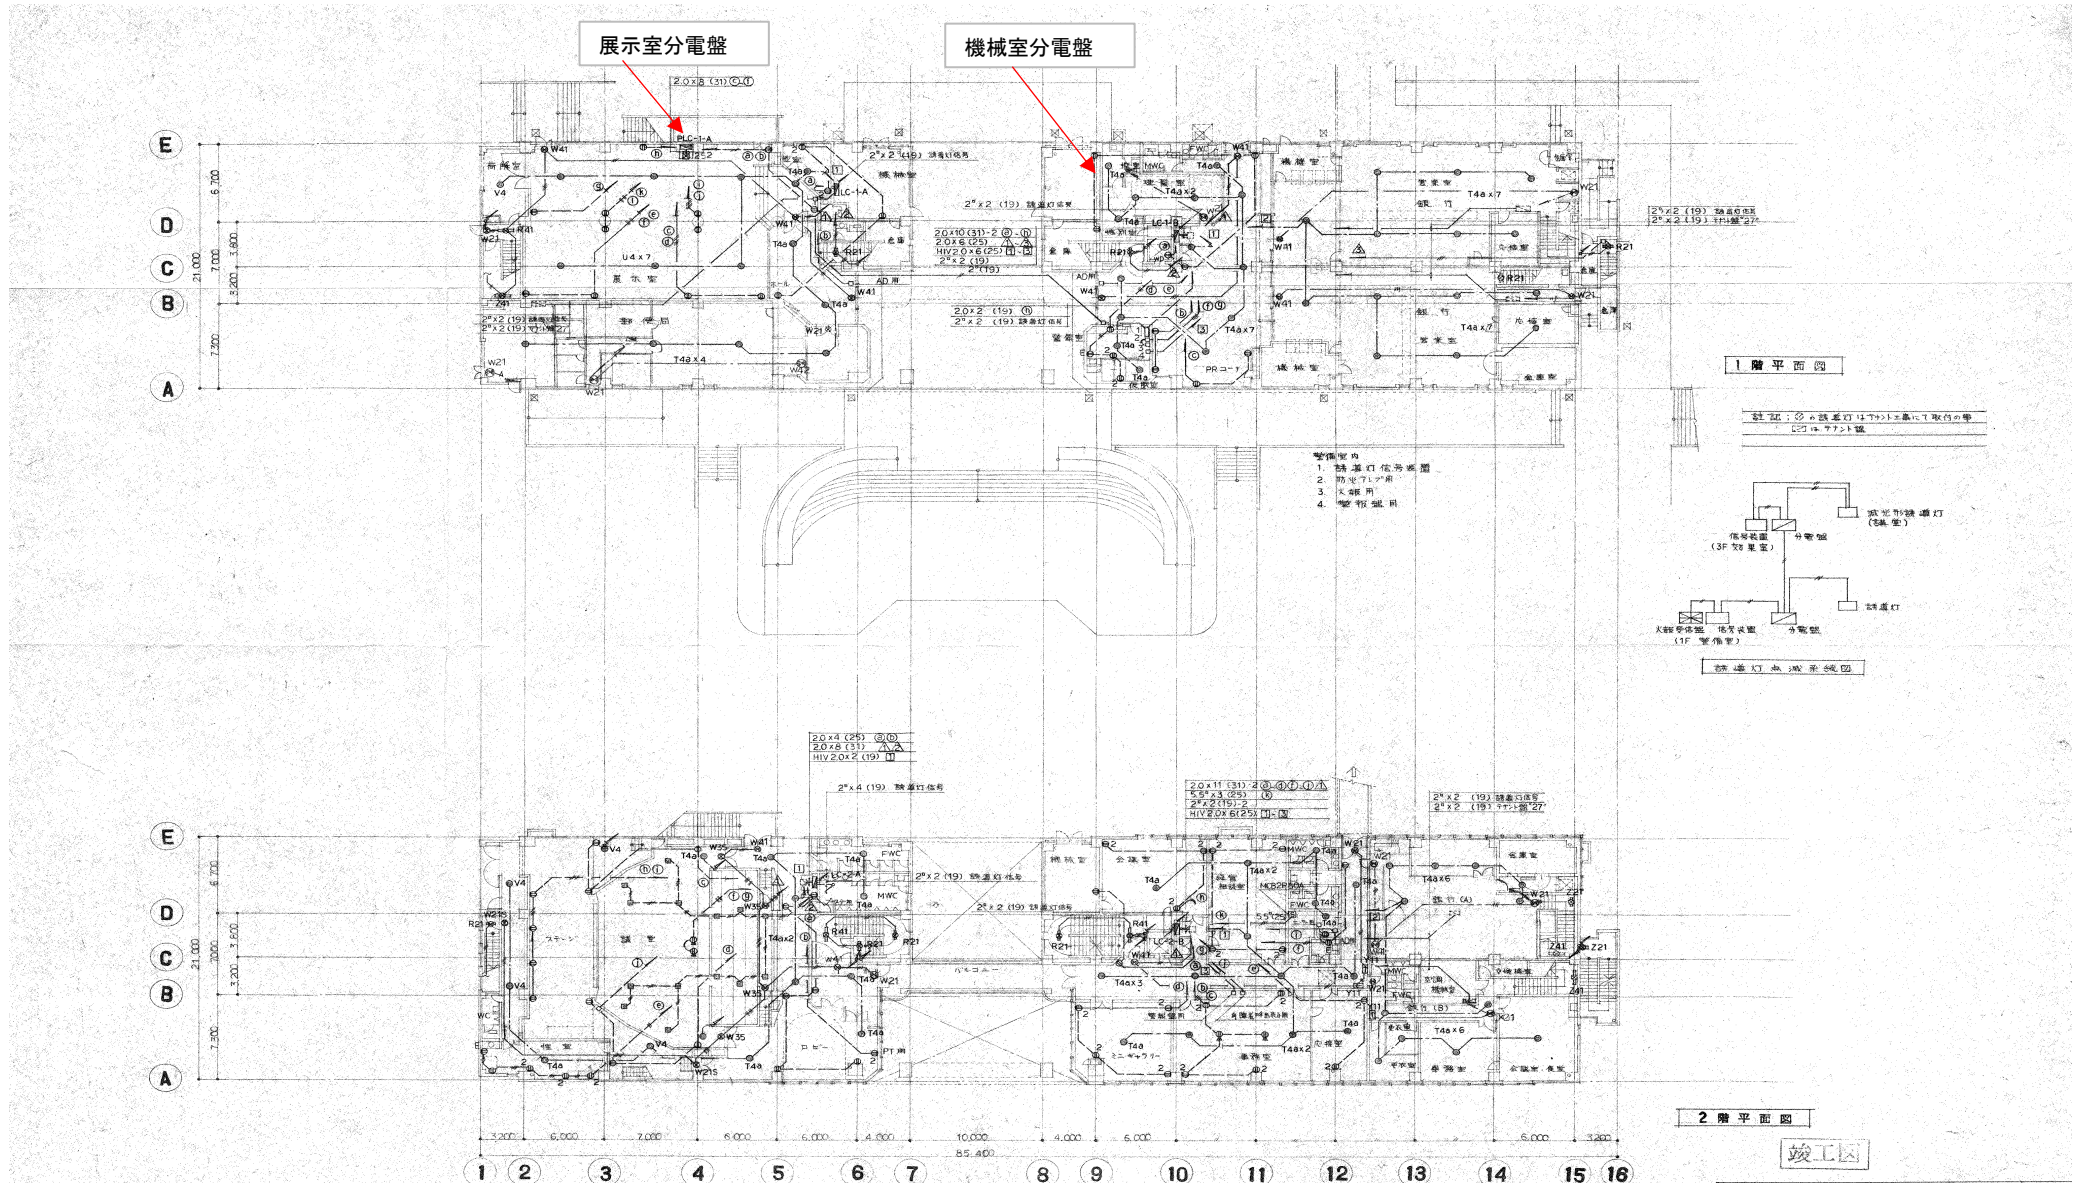


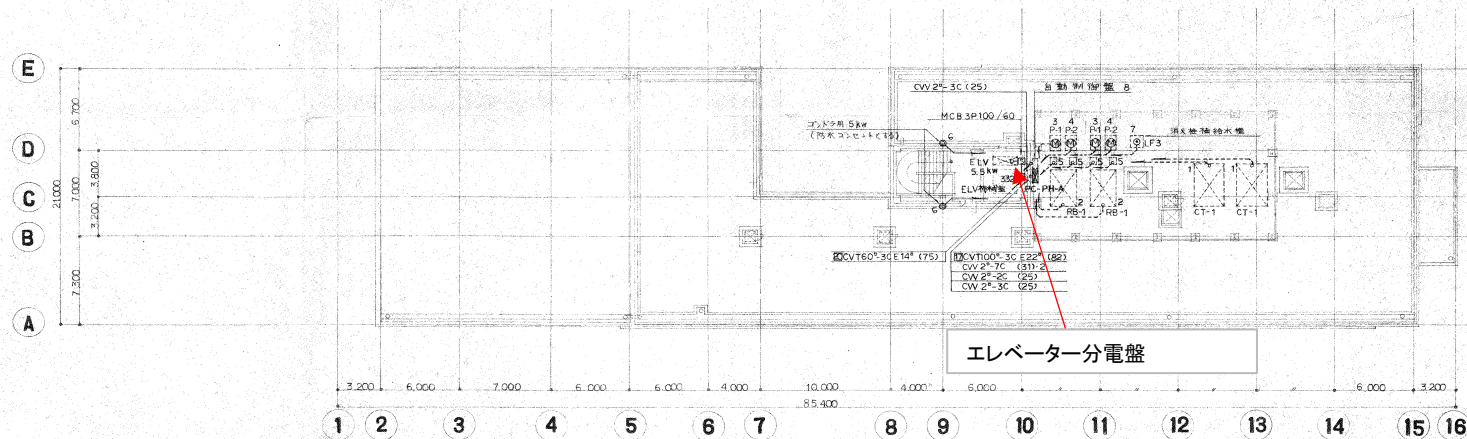


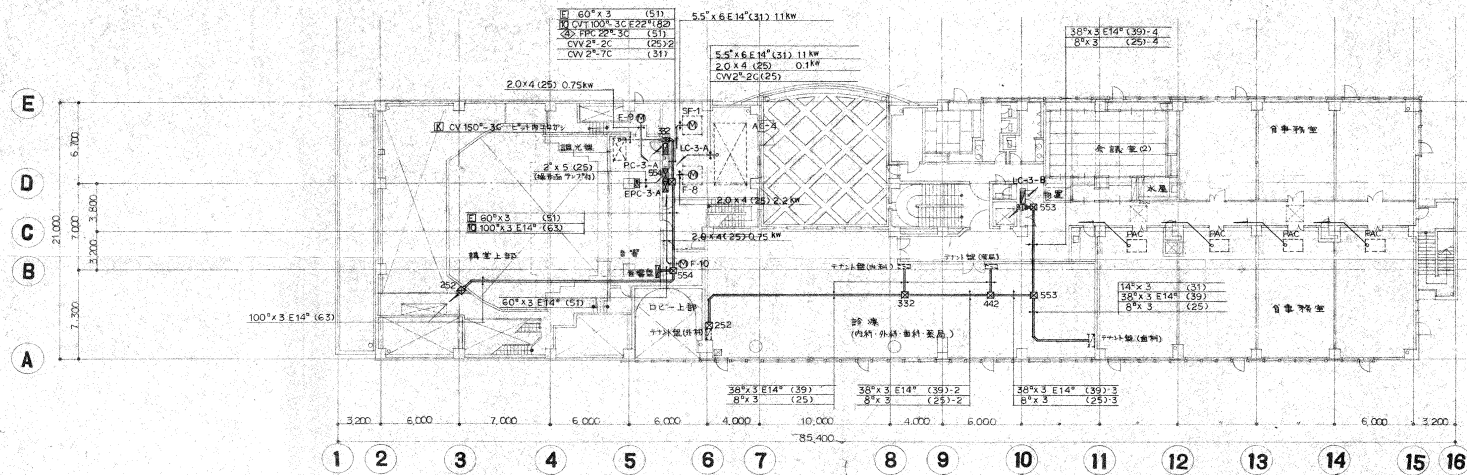



機名	機種No	具名	容量(kW)	配線サイズ
PC-PHA	1	CT-1 冷却機	7.7	CV 6" 3CE 8" (28)
	2	RB-1 冷却機	2.3	CV 3.5" 3CE 2.0 (22)
	3	CT-1 冷却機	—	CV 2" 7C (28)
	4	P-2 冷却機	5.5	CV 5.5" 3CE 5.5 (28)
	5	P-3 冷却機	0.1	CV 3.5" 3CE 2.0 (22)
	6	P-1 冷却機	3.7	CV 3.5" 3CE 2.0 (22)
	7	冷却塔機	5.0	5.5" x 3 E5.5" (25)

竣工図

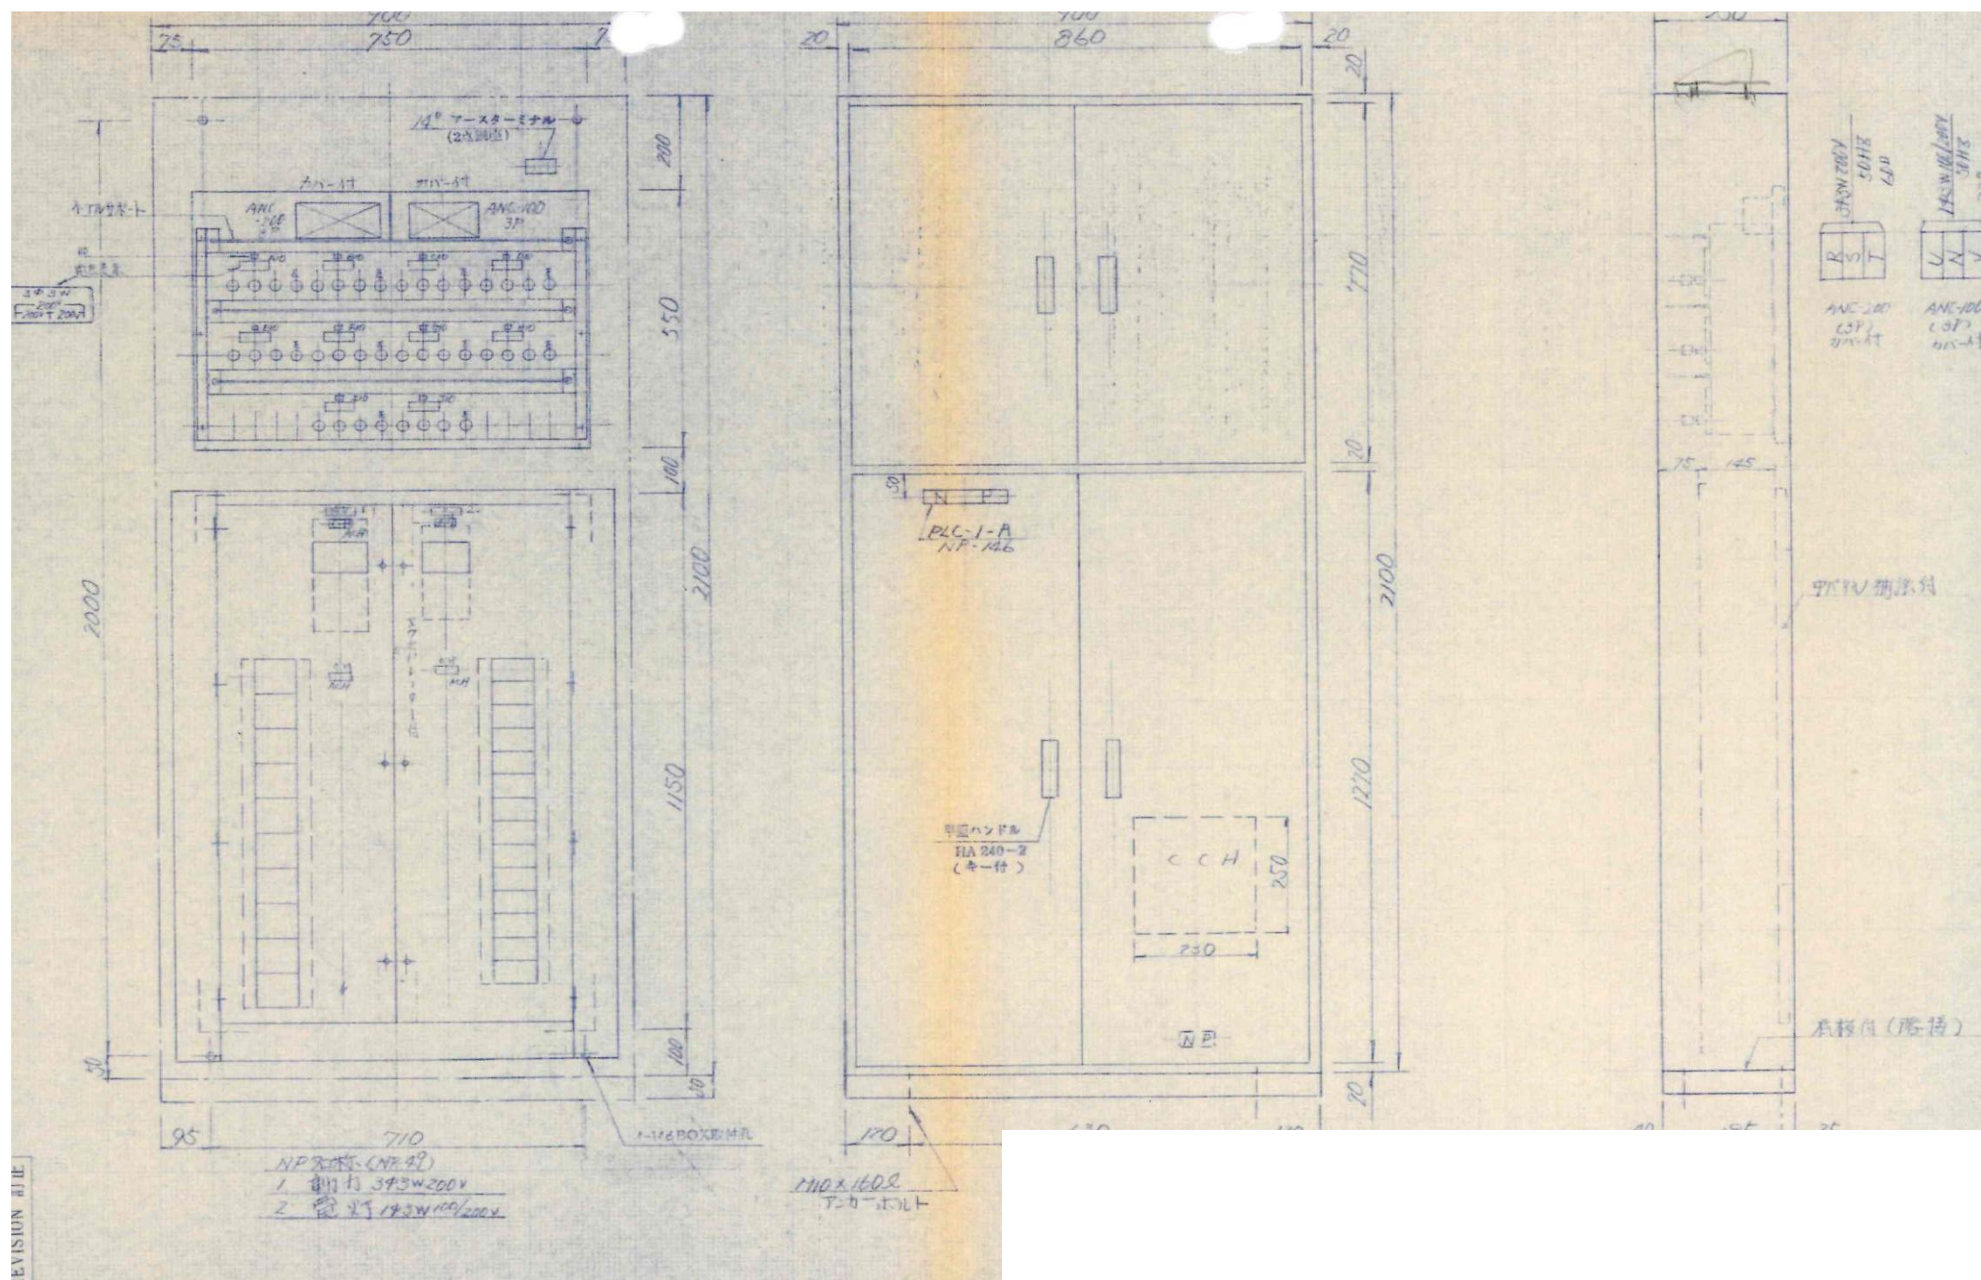


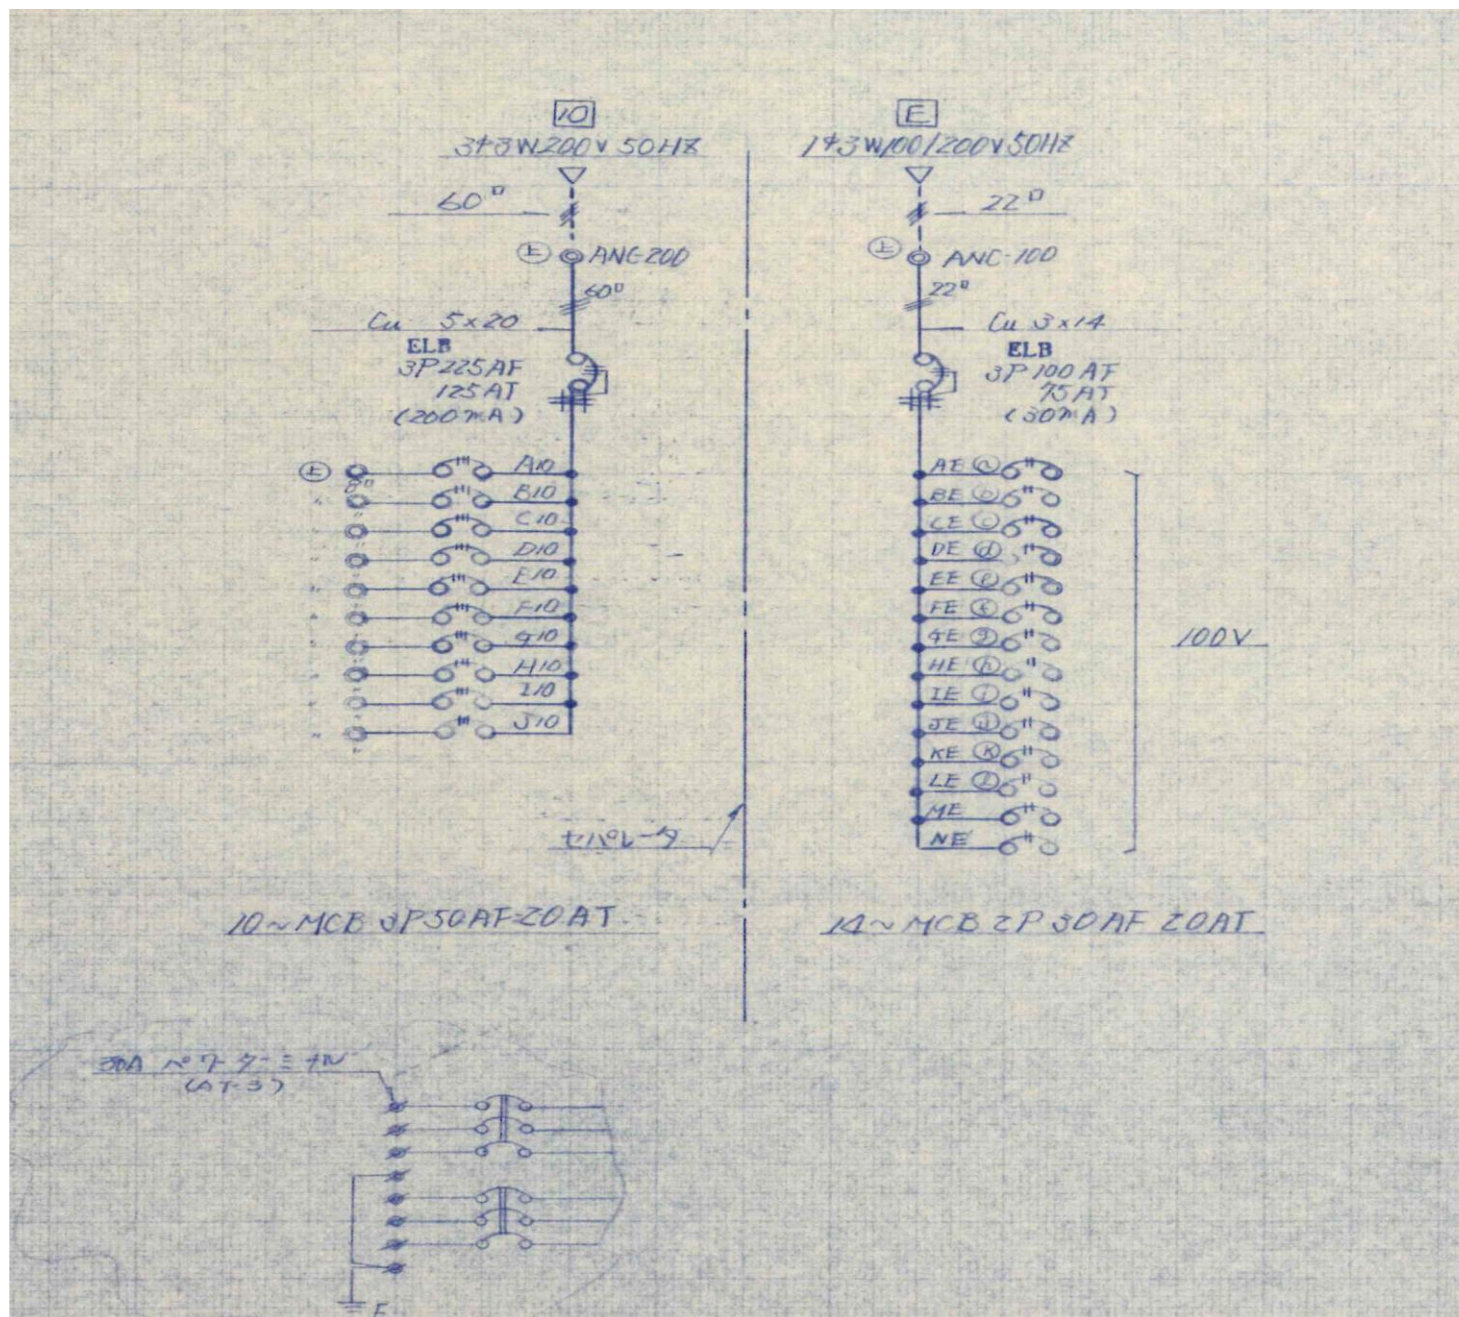

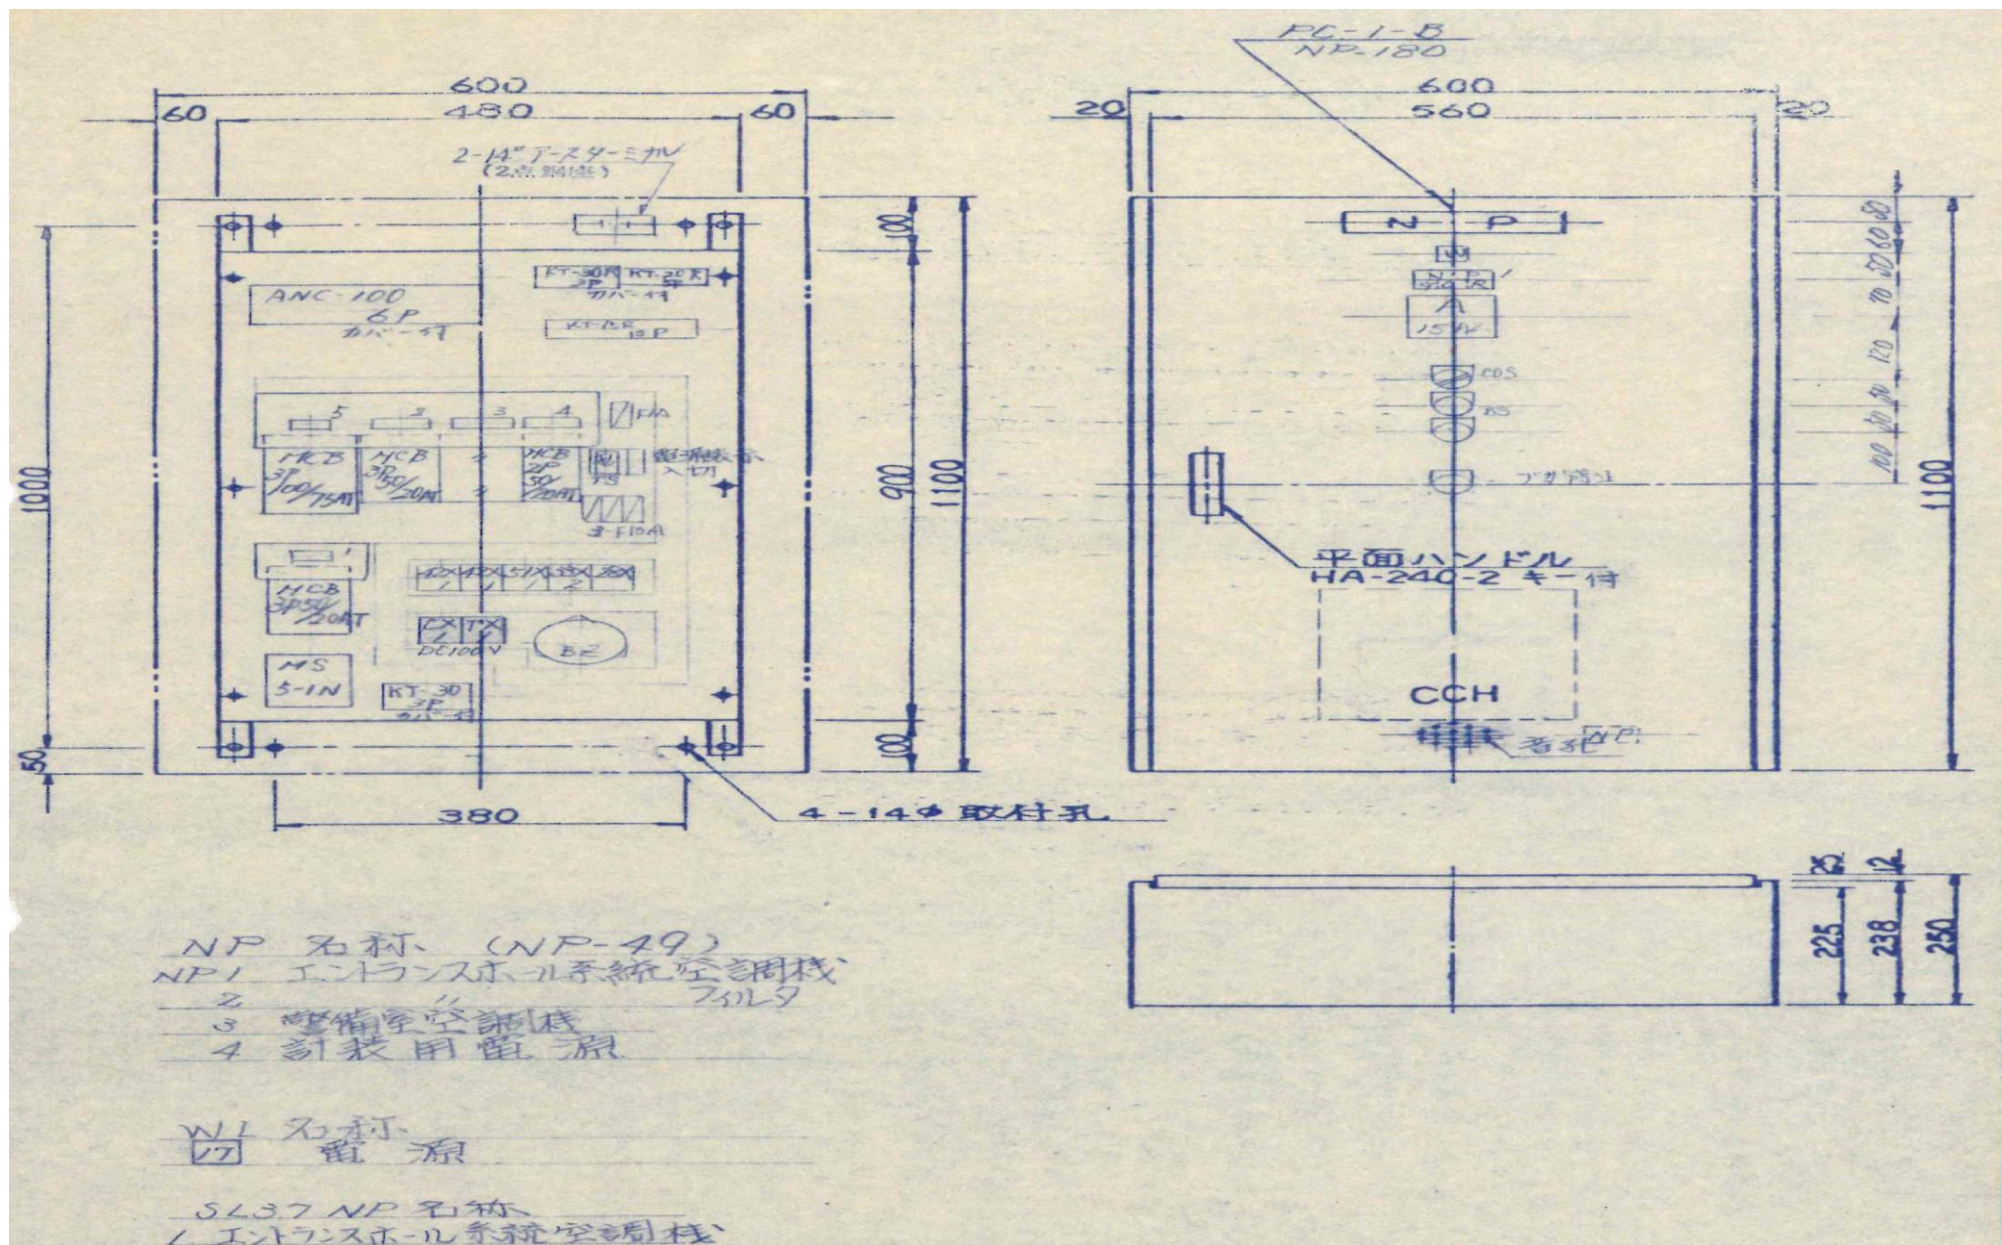


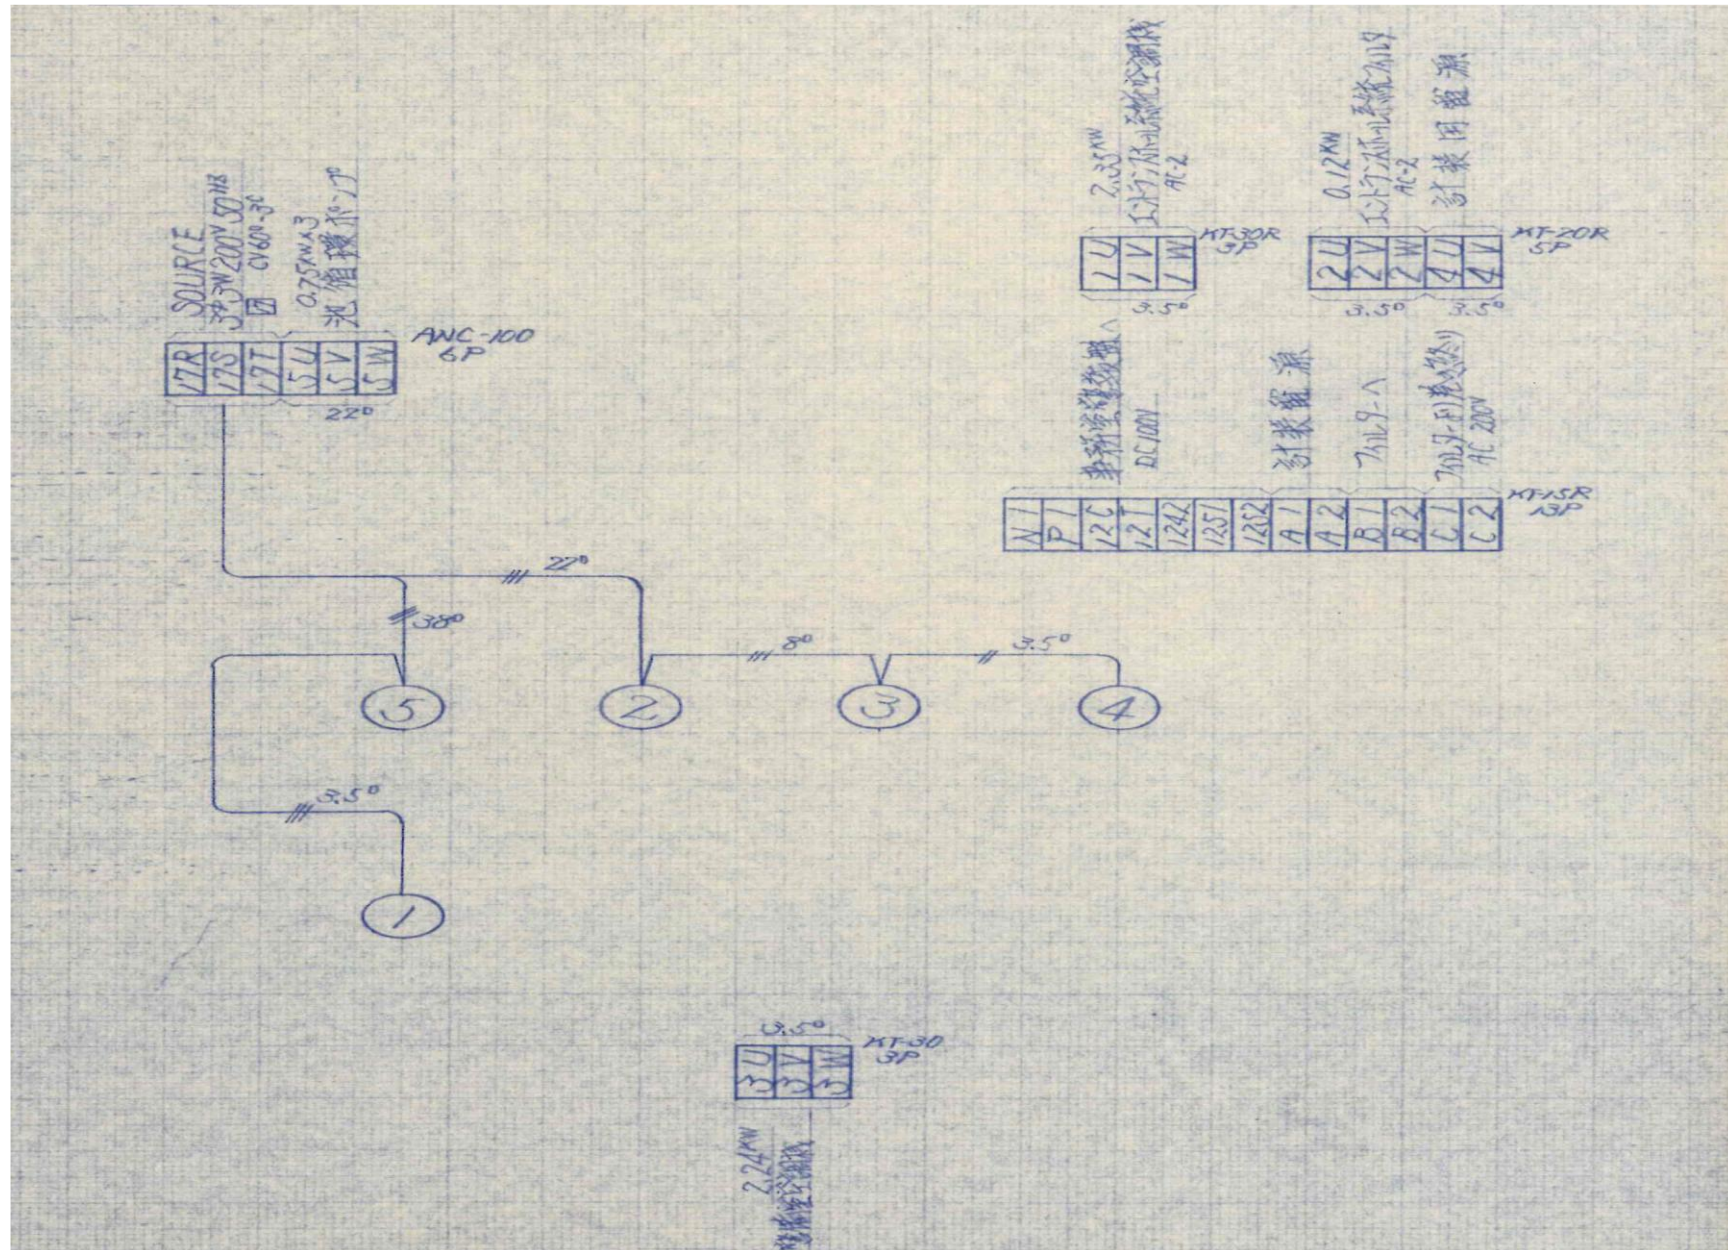




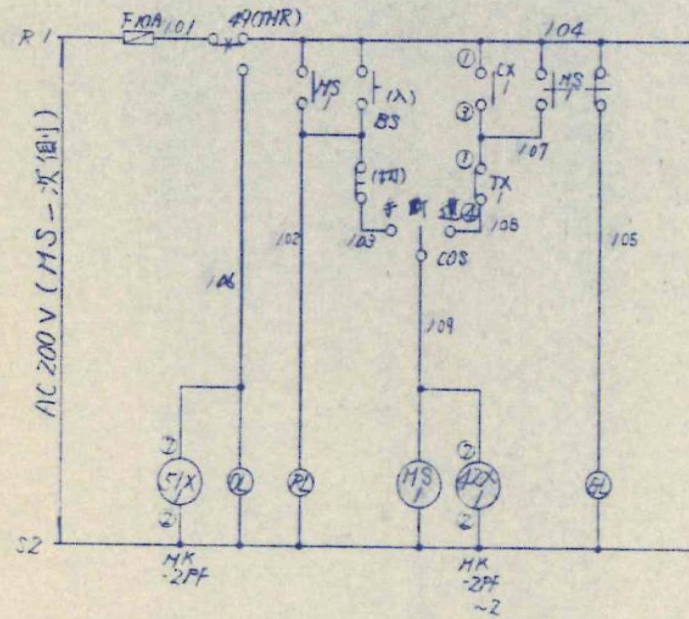

エントランス系統空調機

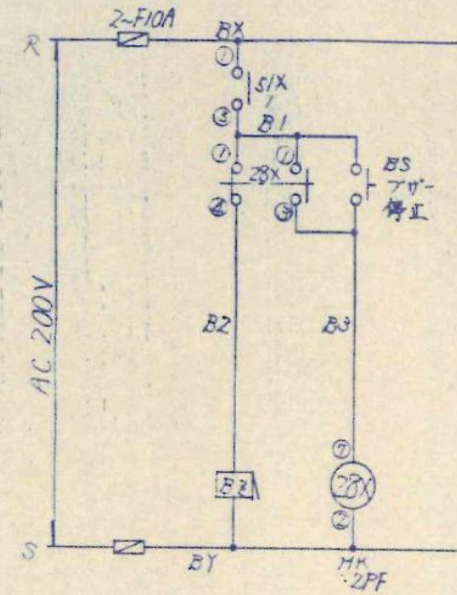

警報回路

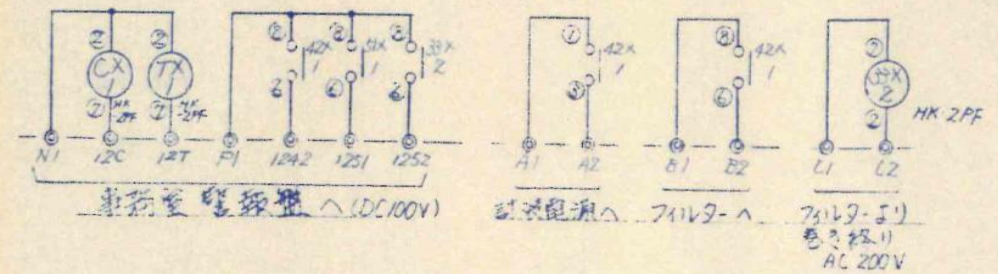



事務室照明盤 (DC100V)


計測電源 (711V9-1)


711V9-2 (AC 200V)





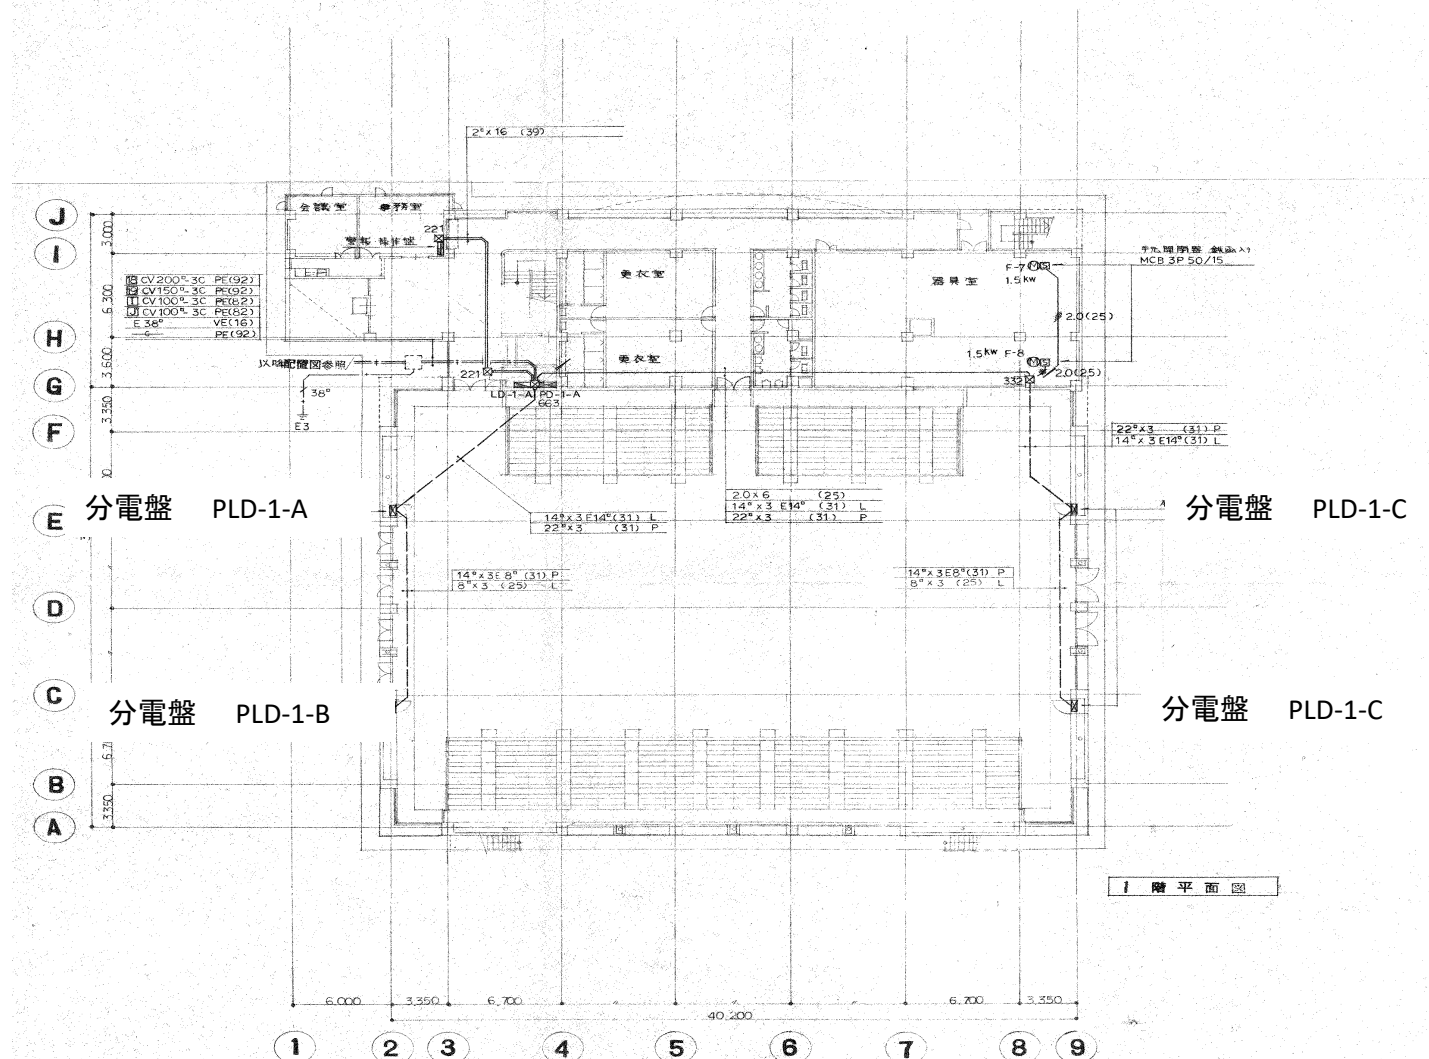




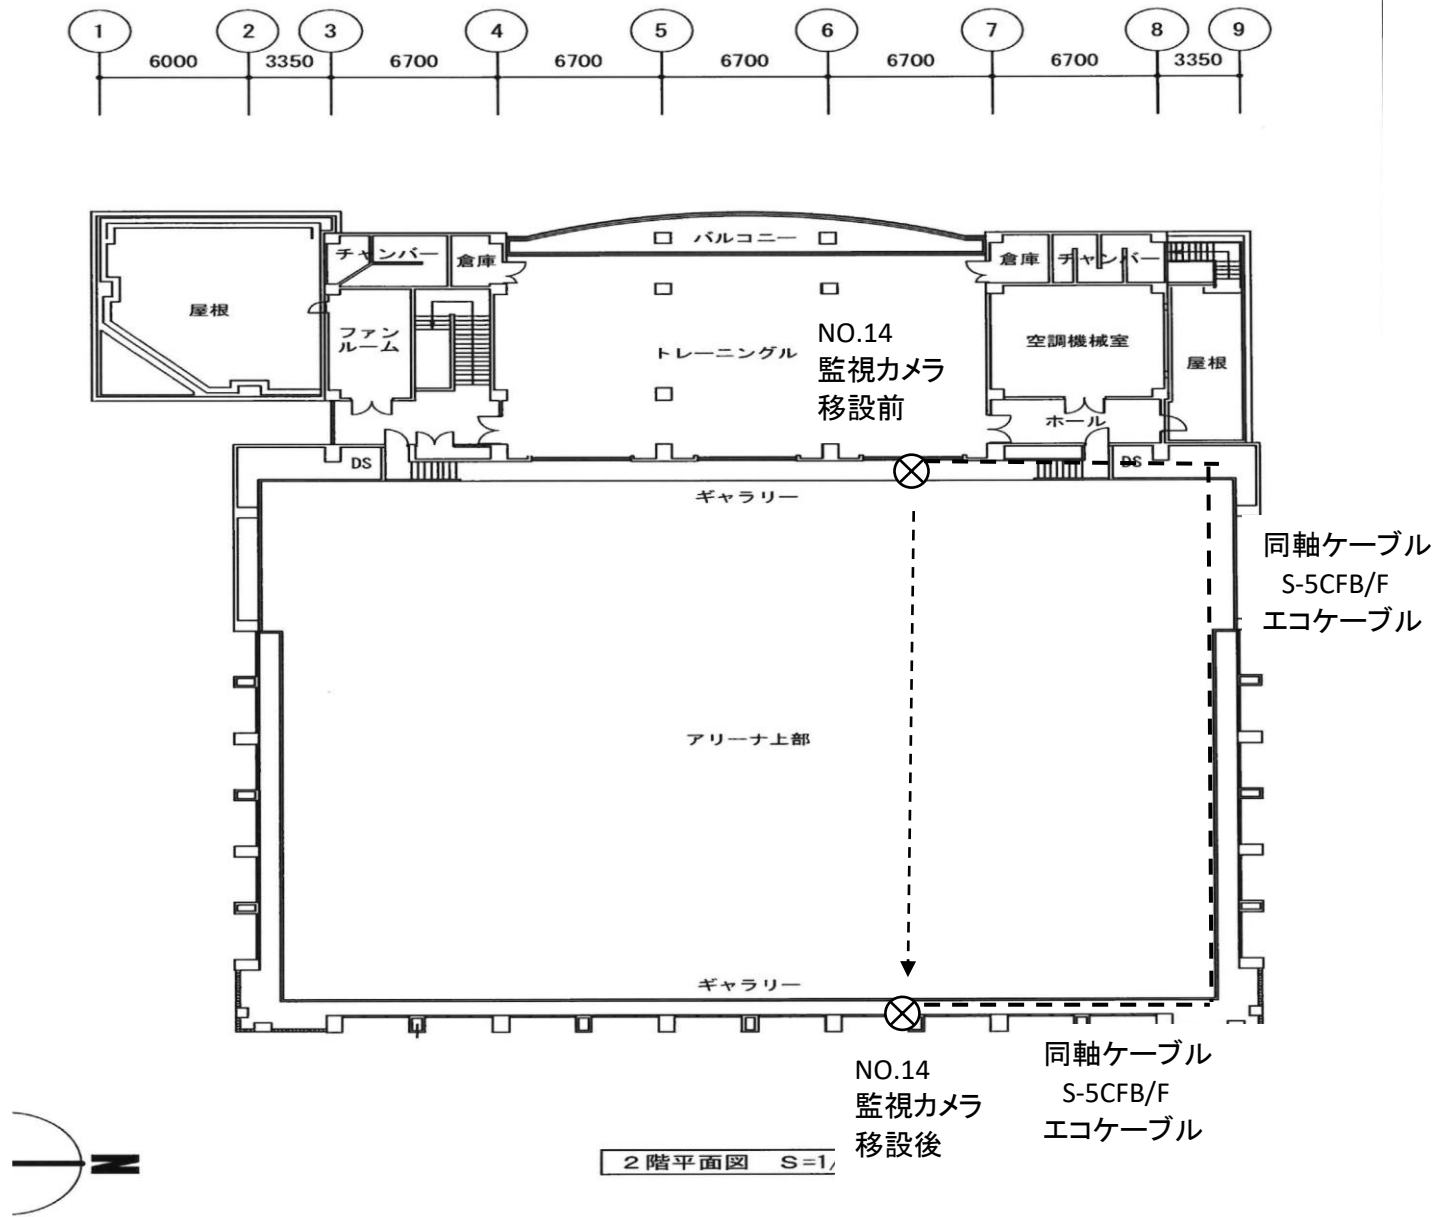


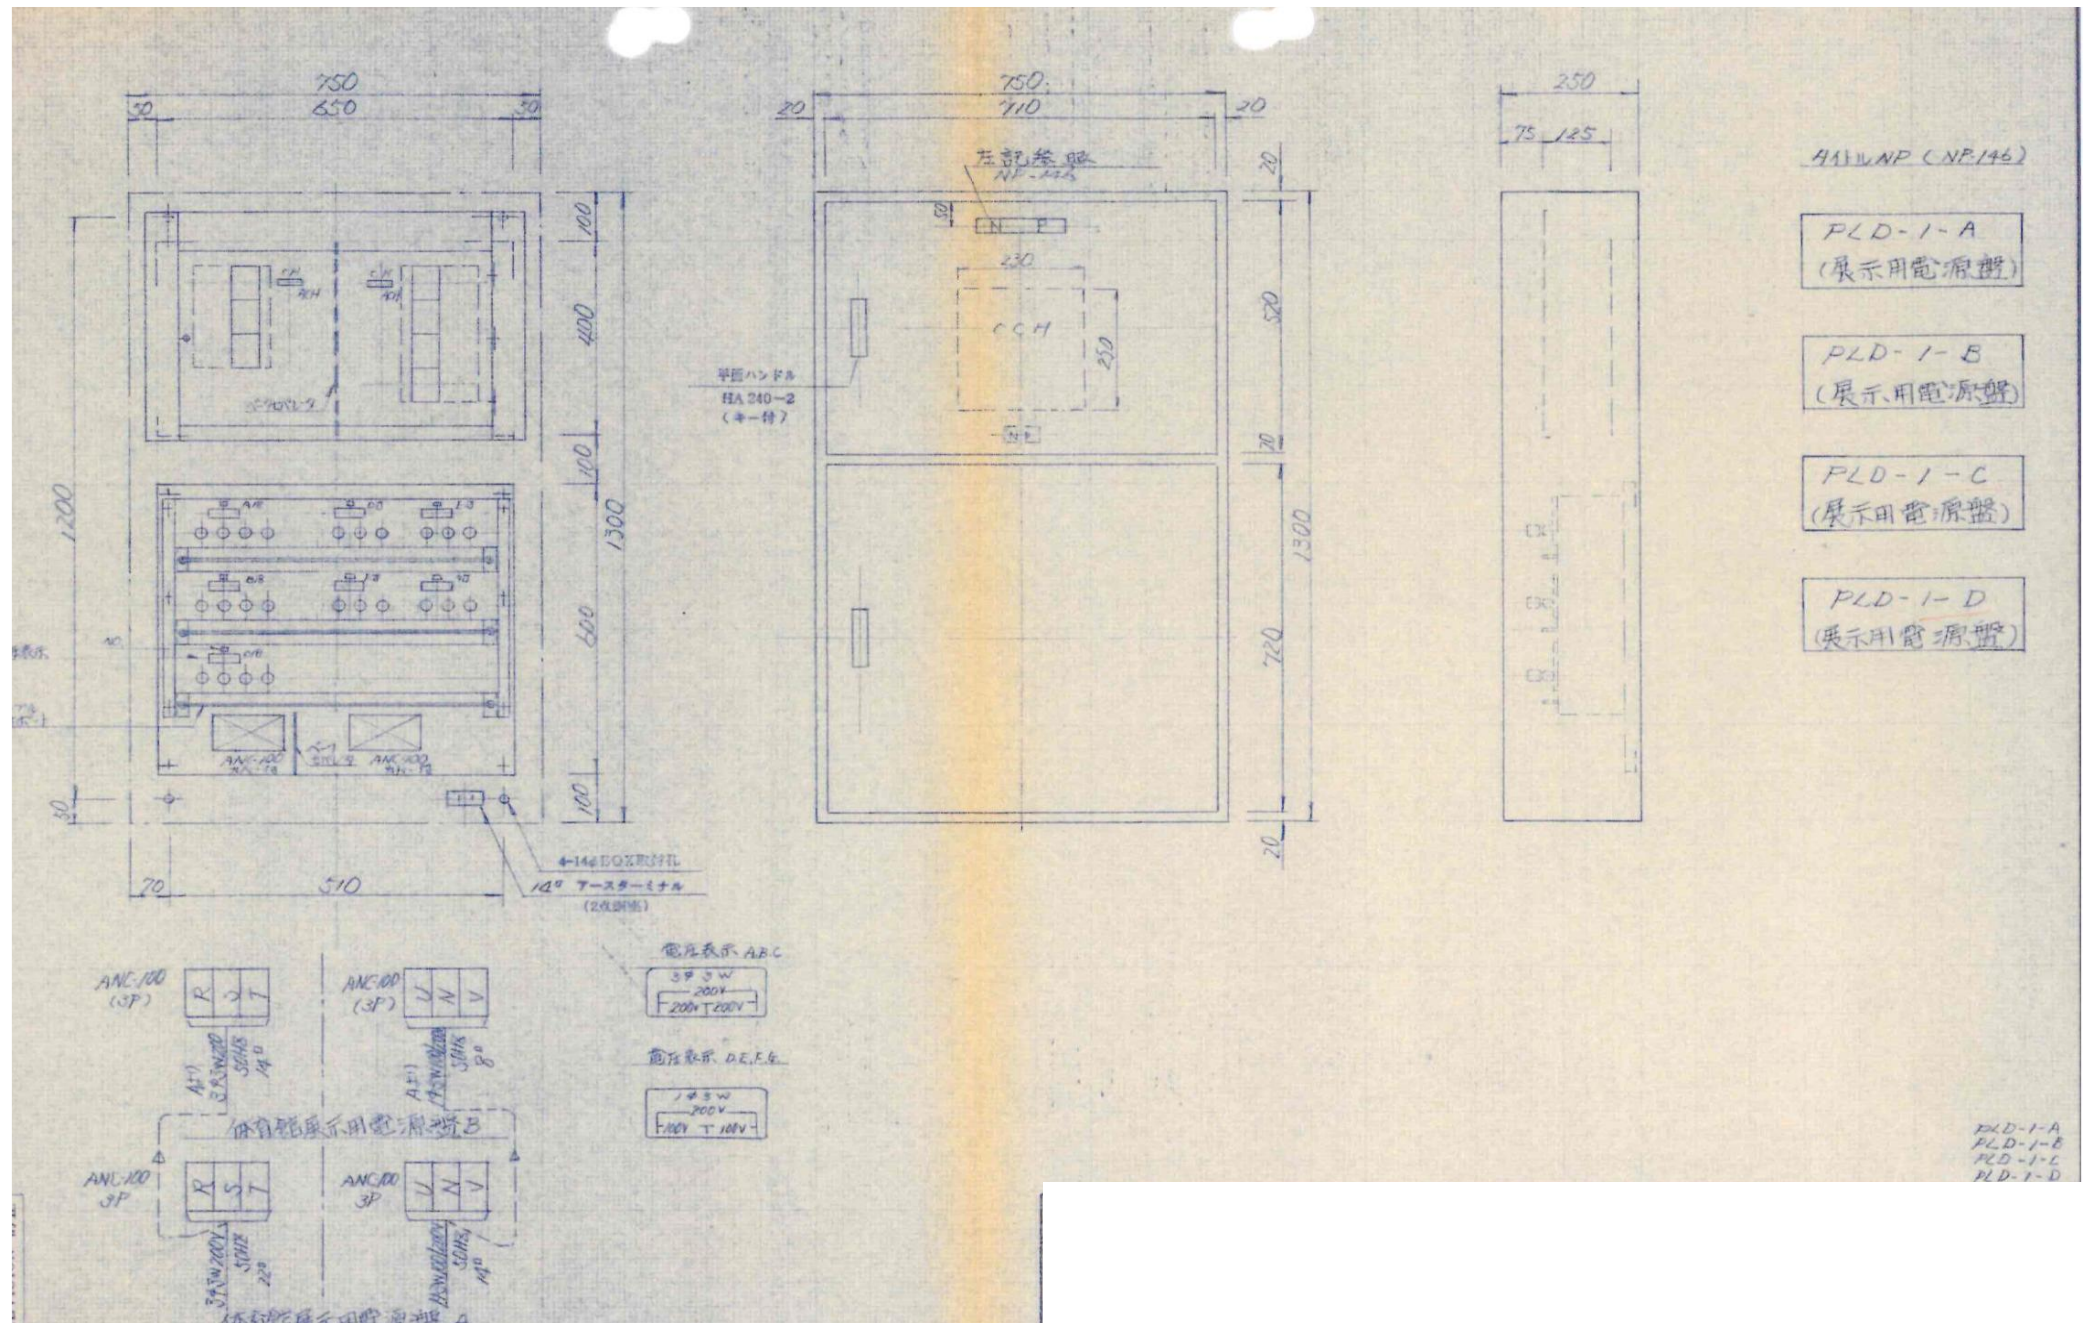

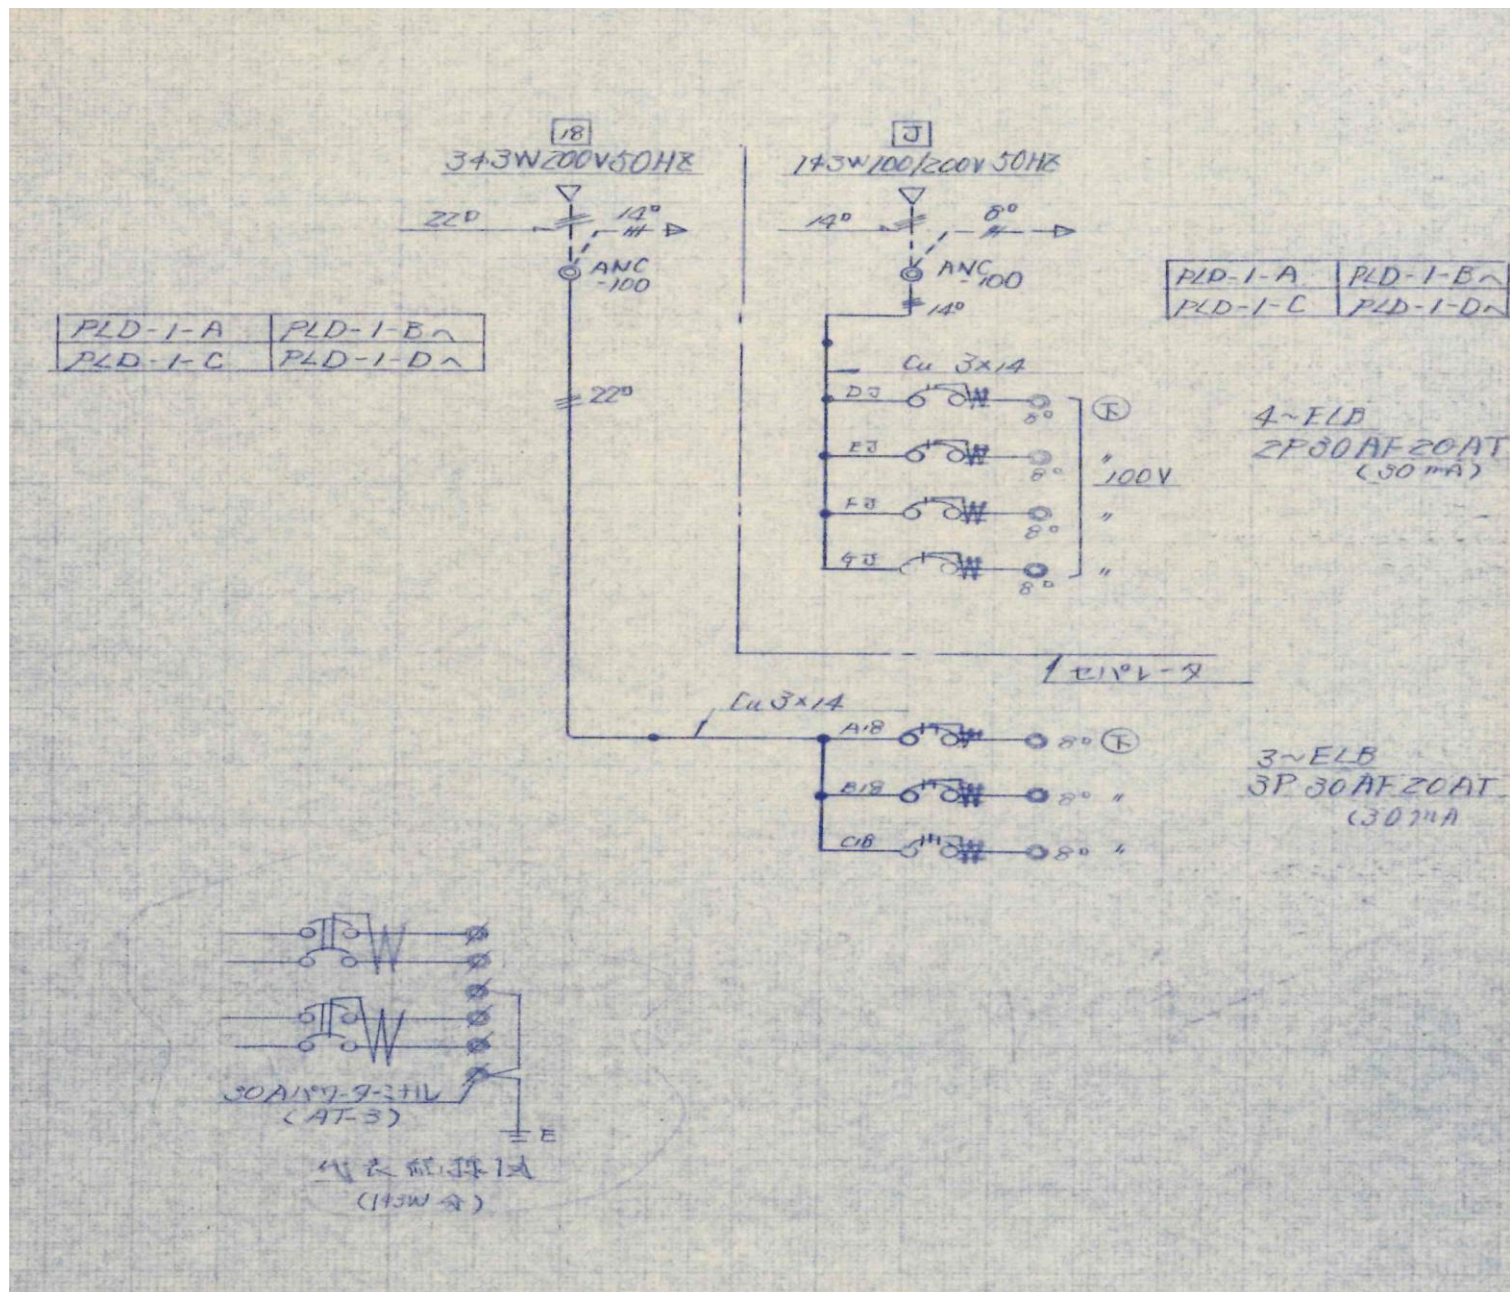

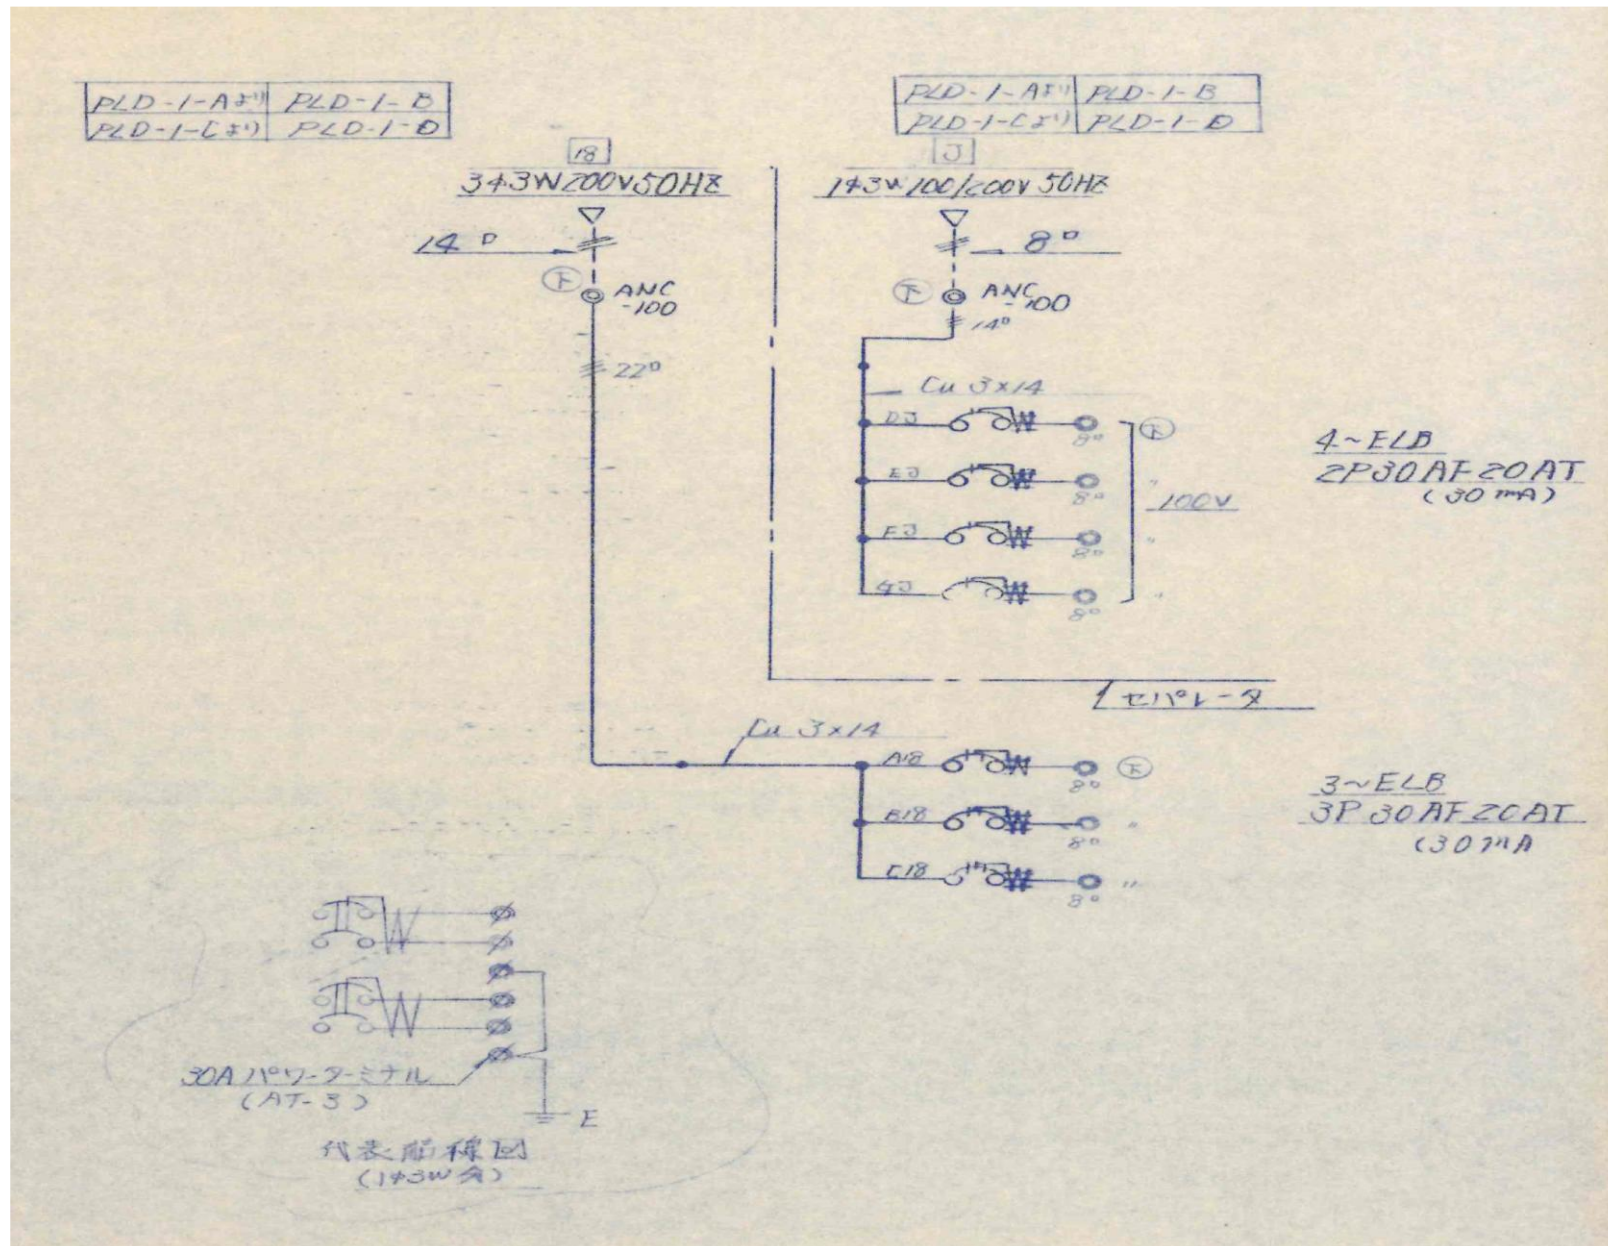

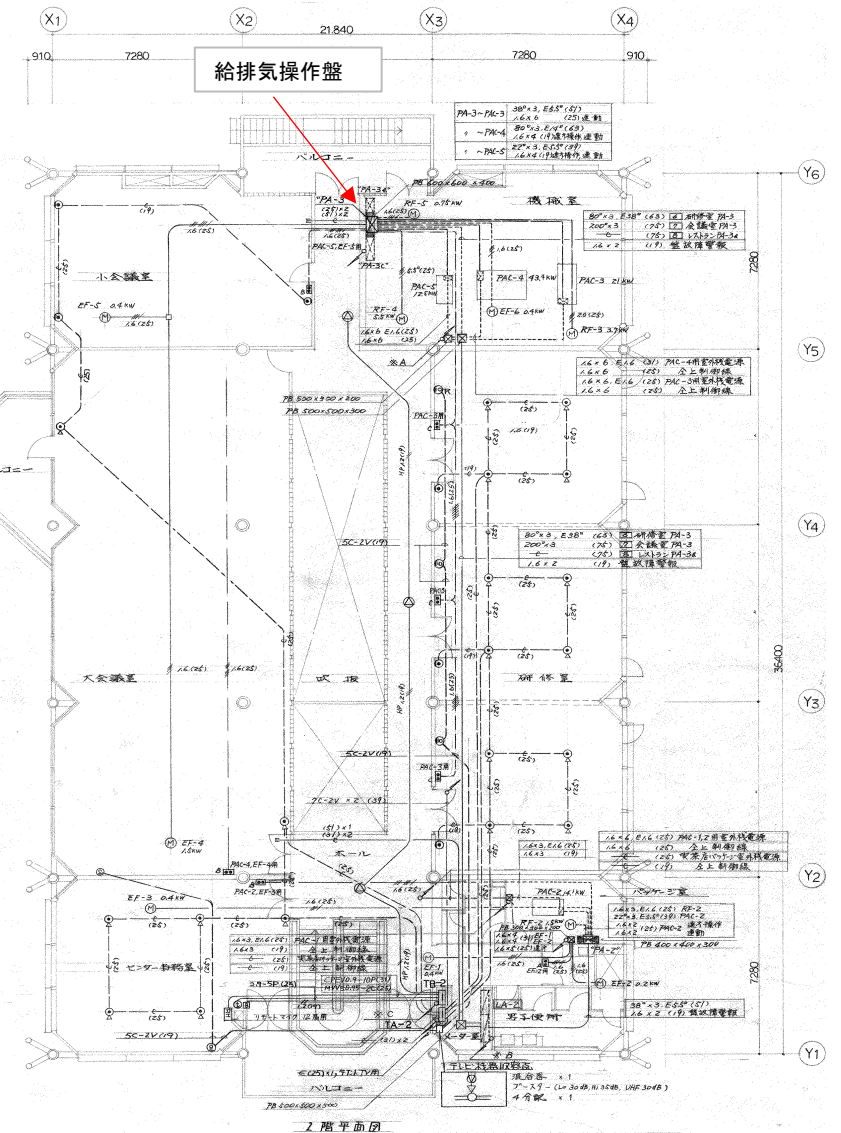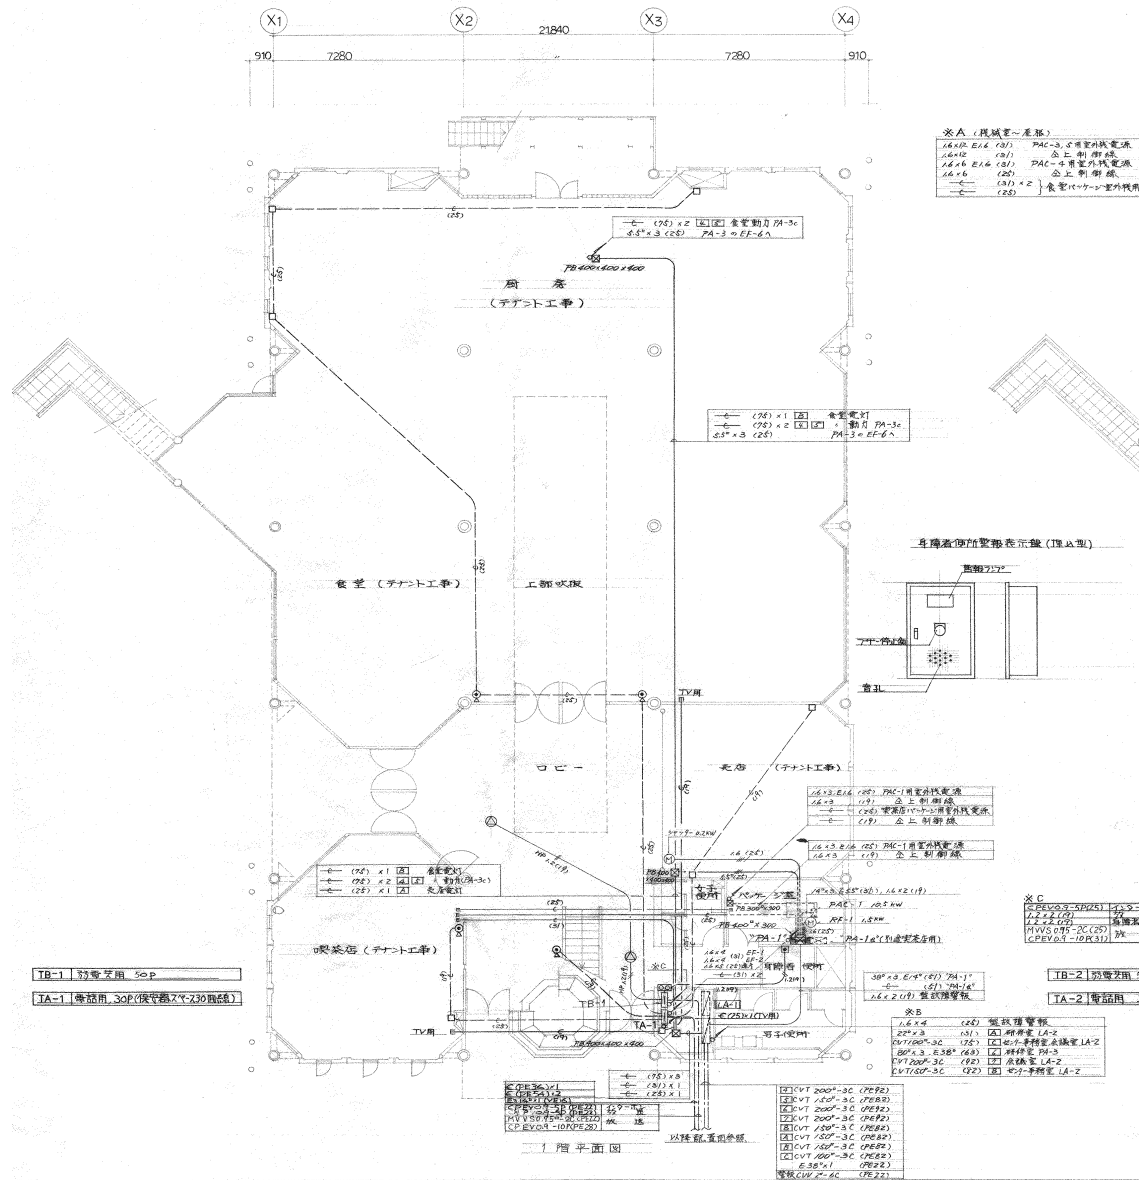

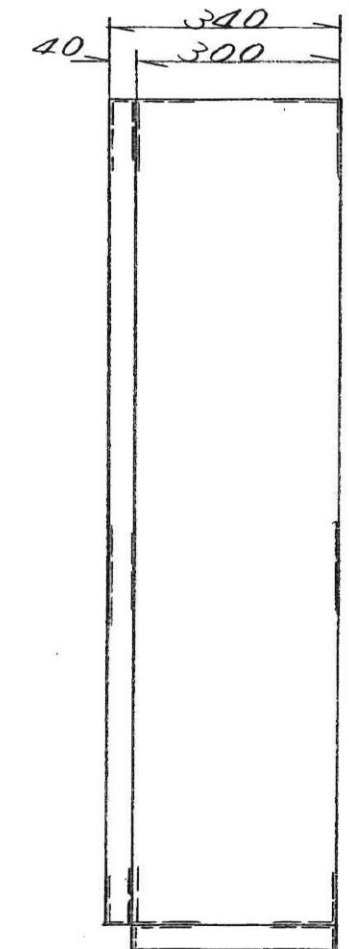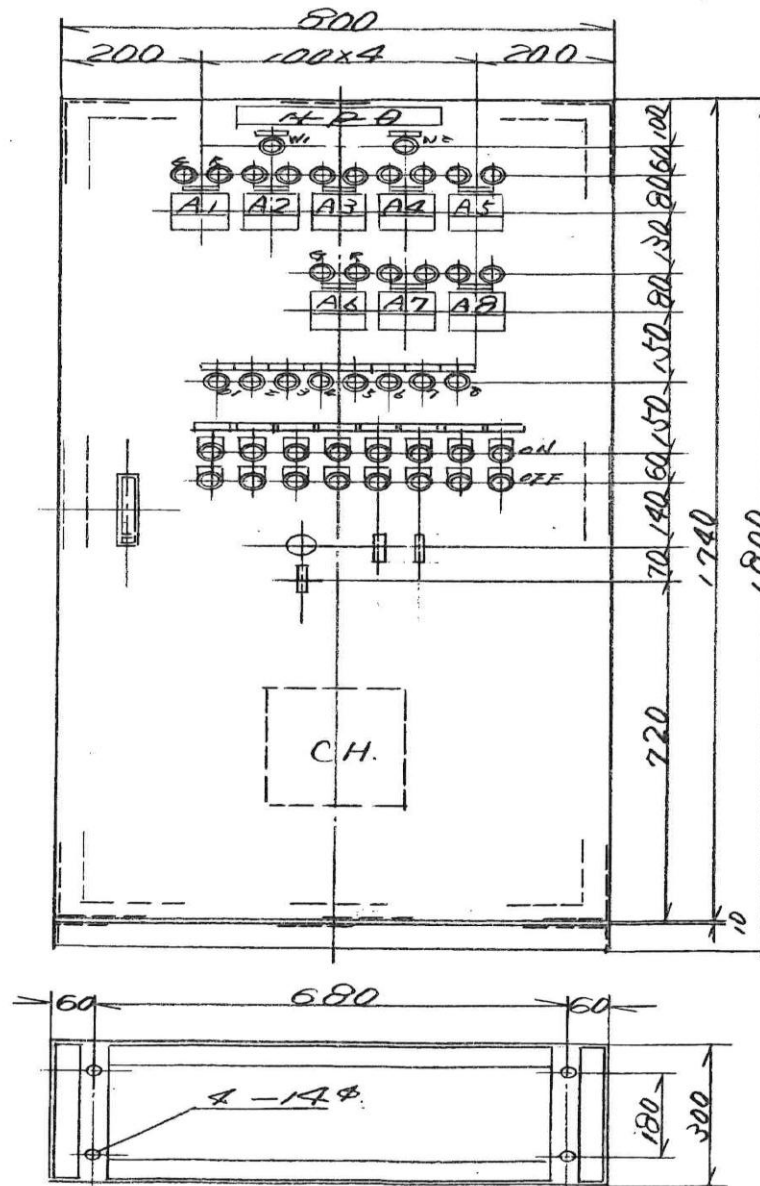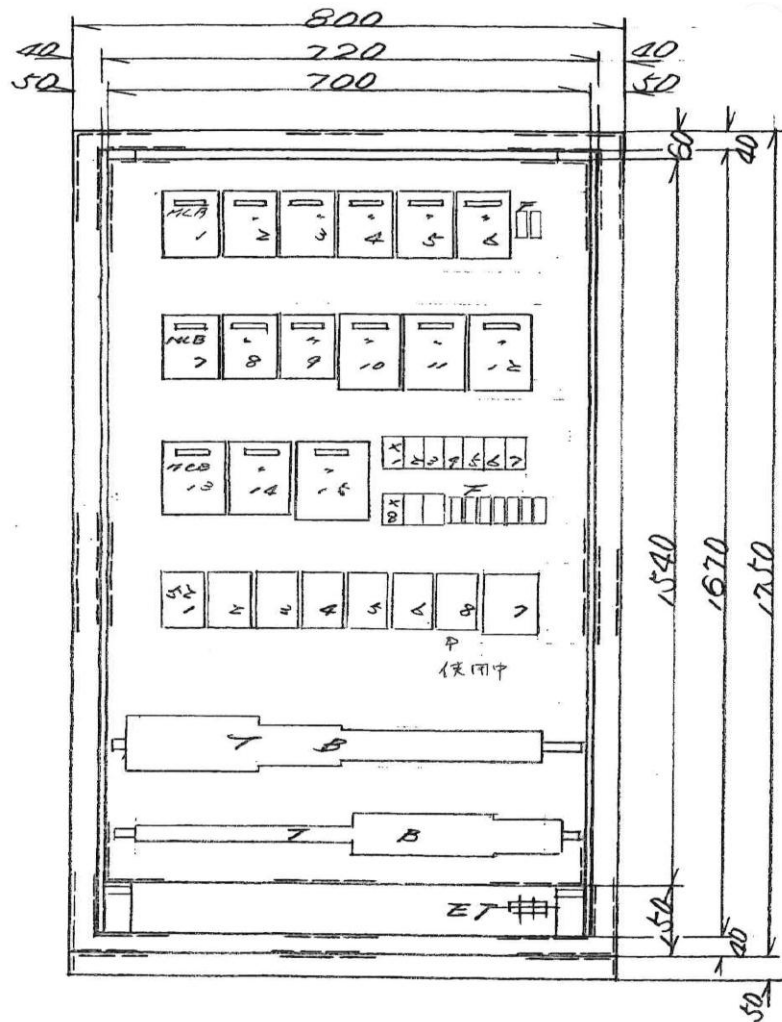

品名 ITEM			
PA-3			
納入先 SUBMITTED TO			
横浜 FV			
照査 CH. BY	設計 DES. BY	製図 DR. BY	報告 IN CHG. C
11			

